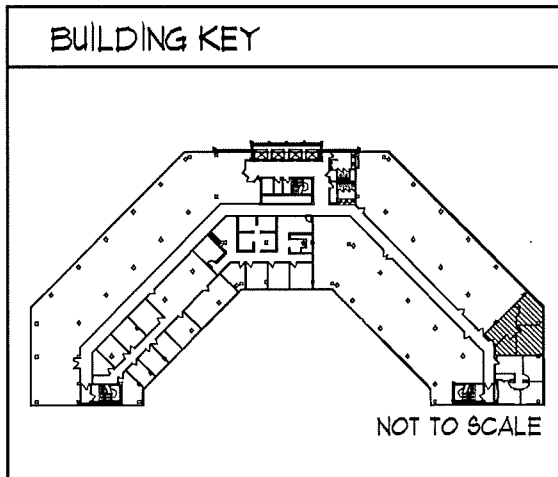

**FLOOR PLAN**  
 1/8" = 1'-0"

THIS PLAN IS AN AS-BUILT DOCUMENT TO BE USED TO DOCUMENT THE EXISTING SPACE. THIS DOCUMENT DOES NOT DETERMINE SPACES COMPLIANCE WITH EXISTING BUILDING CODES.



7807 Creekridge Circle  
 Minneapolis, MN 55439  
 952.897.7874 Fax: 952.897.7740

AS-BUILT FLOOR PLAN  
 SUITE 835  
 SOUTHGATE OFFICE PLAZA  
 5001 W. 80TH ST.  
 BLOOMINGTON, MN

SCALE: AS NOTED  
 JOB: 2002.068.0  
 REVISION: DATE  
 XXX

DRAWN BY: MRL  
 DATE: 07.03.02

**A-1**