



916 RSF.

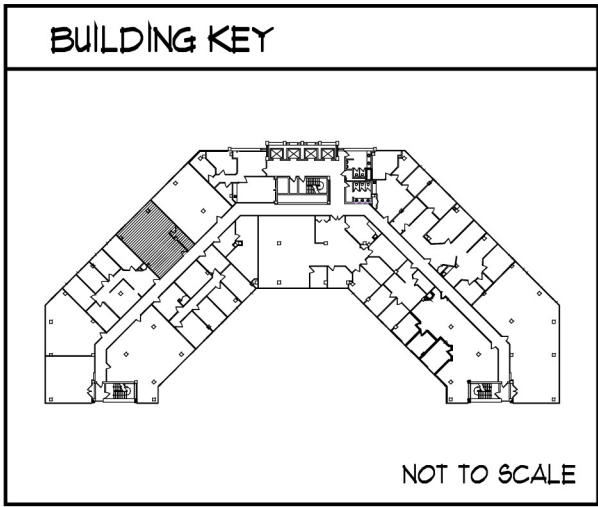

THIS PLAN IS AN AS-BUILT DOCUMENT TO BE USED TO DOCUMENT THE EXISTING SPACE. THIS DOCUMENT DOES NOT DETERMINE SPACES COMPLIANCE WITH EXISTING BUILDING CODES.

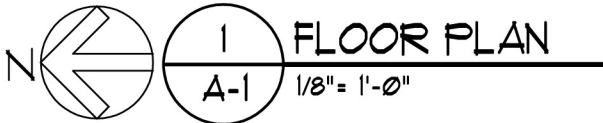

TRANSWESTERN[®]
 706 2nd Avenue South
 100 Baker Building
 Minneapolis, MN 55402
 (612) 343-4200

AS-BUILT FLOOR PLAN
 SUITE 667
 SOUTHGATE OFFICE PLAZA
 5001 AMERICAN BLVD.
 BLOOMINGTON, MN

SCALE:	AS NOTED	DRAWN BY:	CRH
JOB:	2004.0000	DATE:	06.16.04
REVISION:	DATE		
▲	XXX		

A-1